

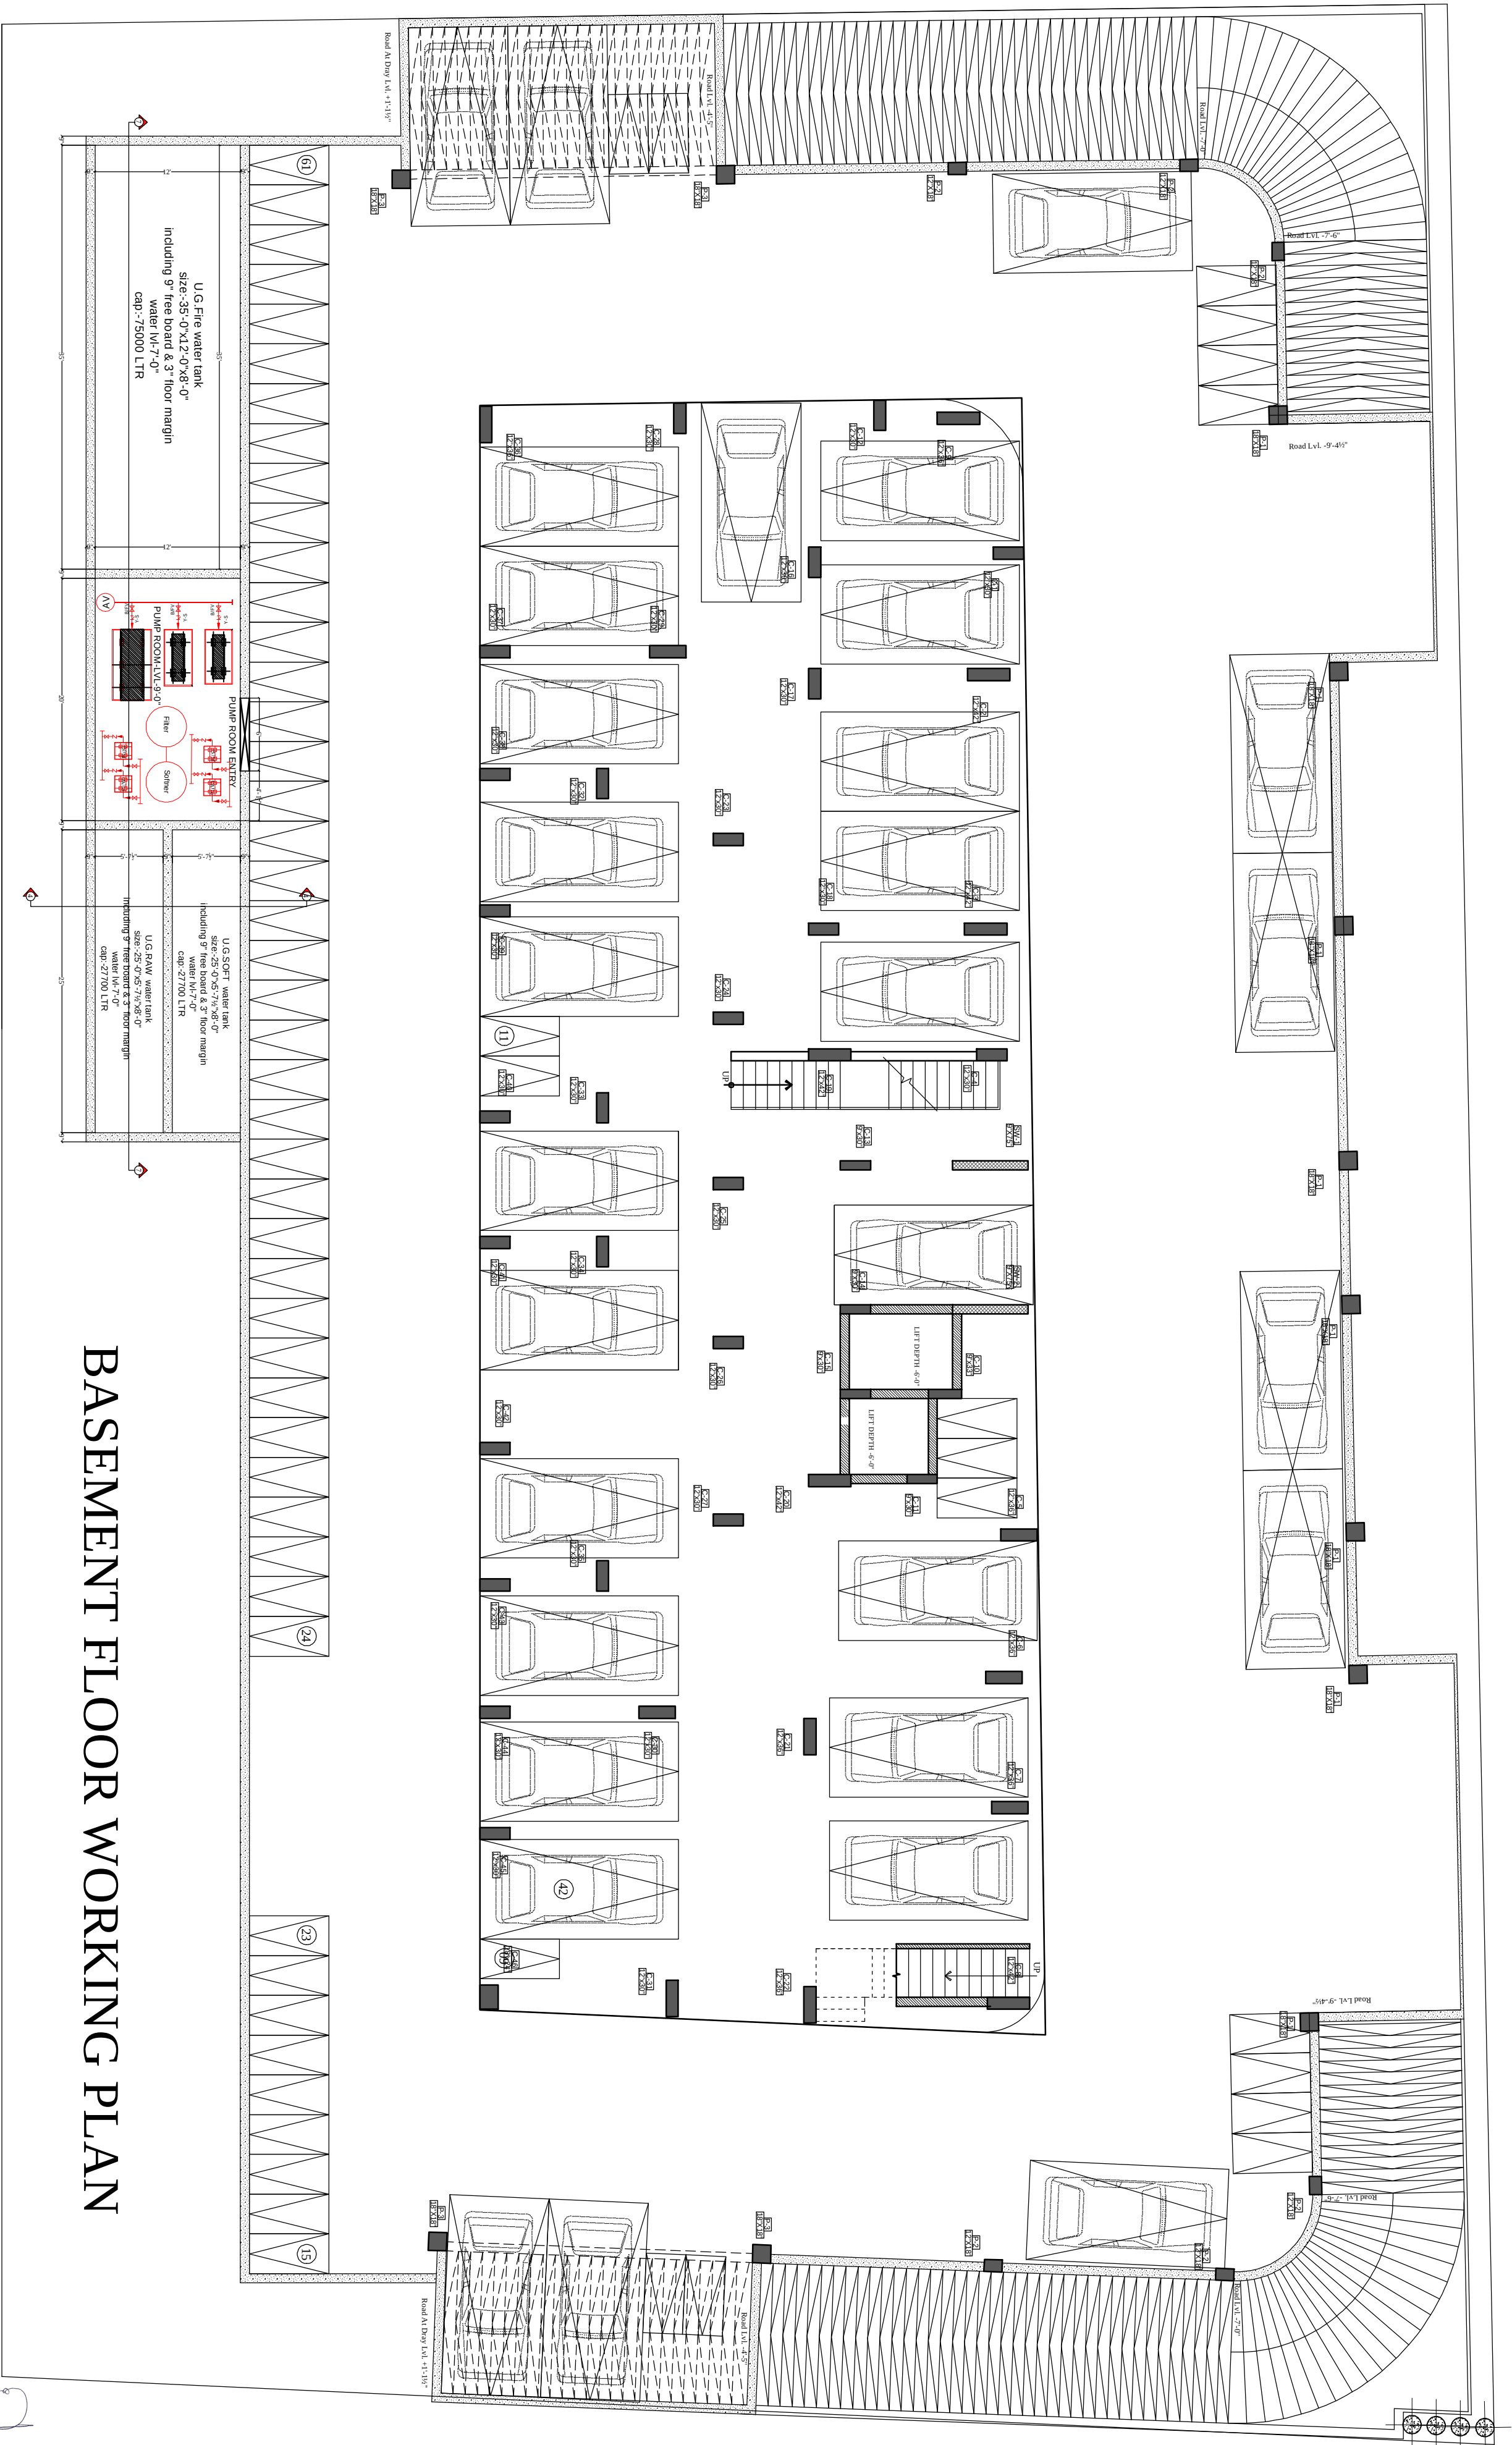


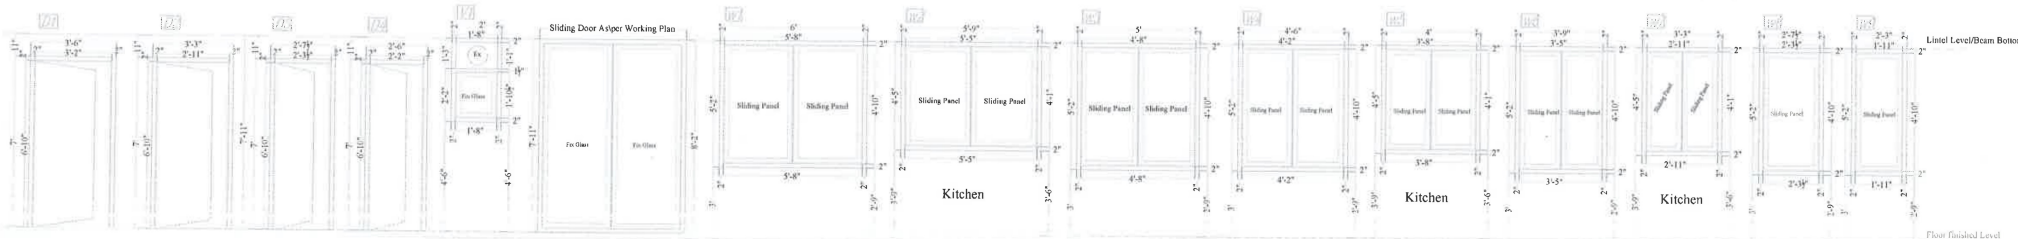

BASEMENT FLOOR WORKING PLAN

SHRI KRISHNAN
Architect
CA/89/25451

PROJECT:-KIARA APARTMENT		SCALE:- N.T.S.		ARCHITECT :- SPACE GRID	
PRAMOTER:-M/S LALIT MENGHNANI				C-49 KIRGA Apartment prms Mang Bapu Nagar near Janta Store Circle, Jaipur-302015 Ph-09334948766,0141-4005506 (o) Email-rhio.spacegrid@gmail.com	
Basement Floor Working Drawing					
PROJECT:-	ASBUILT RESIDENTIAL FLATS IN	DRN.	Rakesh Saini		
	KHASRA NO. = 625/2,626/1 MAHAL ROAD, JAGATPURA, JAIPUR. (RAJ.)	APPD.	Shri Krishan Sharma		

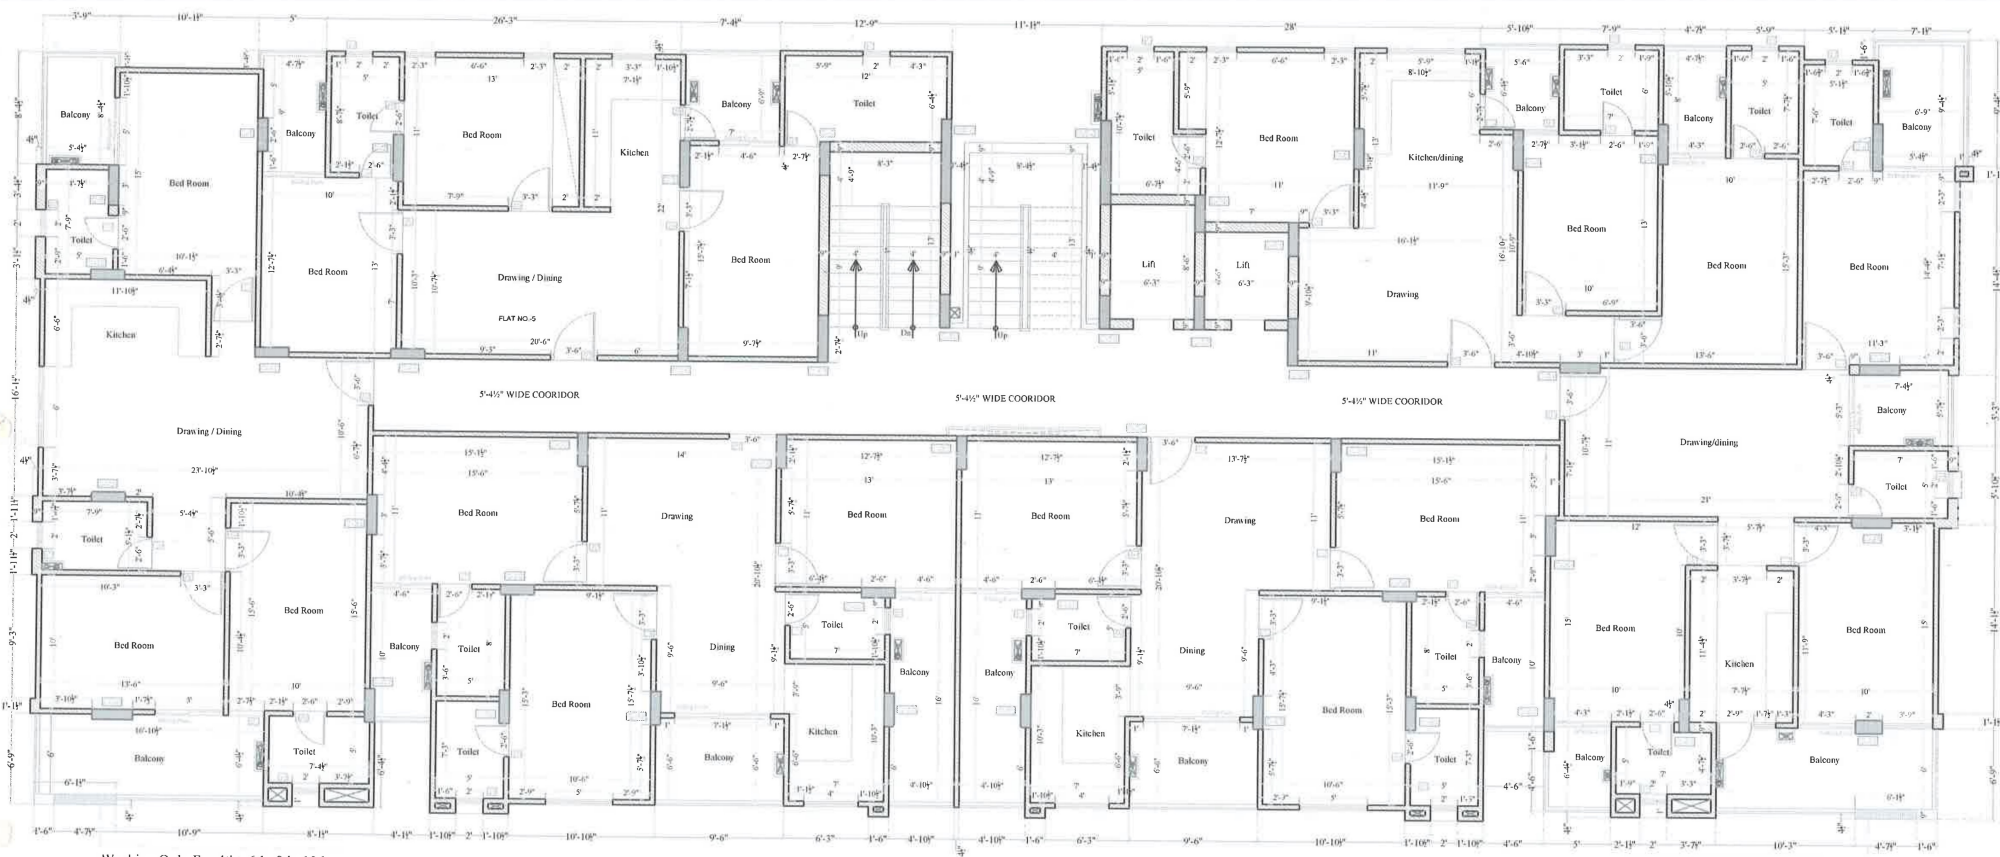

Plaster Unfinished Level
Window SH 3-3' - Linel Lvl As per Beam Bottom
Toilet SH 4-3' - Linel Lvl As per Beam Bottom
Window SH 3-6-5' - Linel Lvl As per Beam Bottom
All Linel Lvl. Door - 7-3' Lvl 8-3' - Linel Lvl As per Beam Bottom

2ND TO 12TH FLOOR WORKING DRAWING

PROJECT:-KIARA APARTMENT
PRAMOTER:-M/S LALIT MENGHNANI


ASBUILT RESIDENTIAL FLATS IN
KHASRA NO. = 625/2.626/1
MAHAL ROAD, JAGATPURA, JAIPUR. (RAJ.)

SCALE :-
DRN.
APPD.

SHRI KRISHAN
Architect
CA/99/25451

ARCHITECT :-
Rakesh Saini
Shri Krishan Sharma

SPACE GRID
C-45000 Apartment, Jaipur, India
JANU-2023
P-09314918766-0141-4005506 (H)
Email: info@spacegrid.in

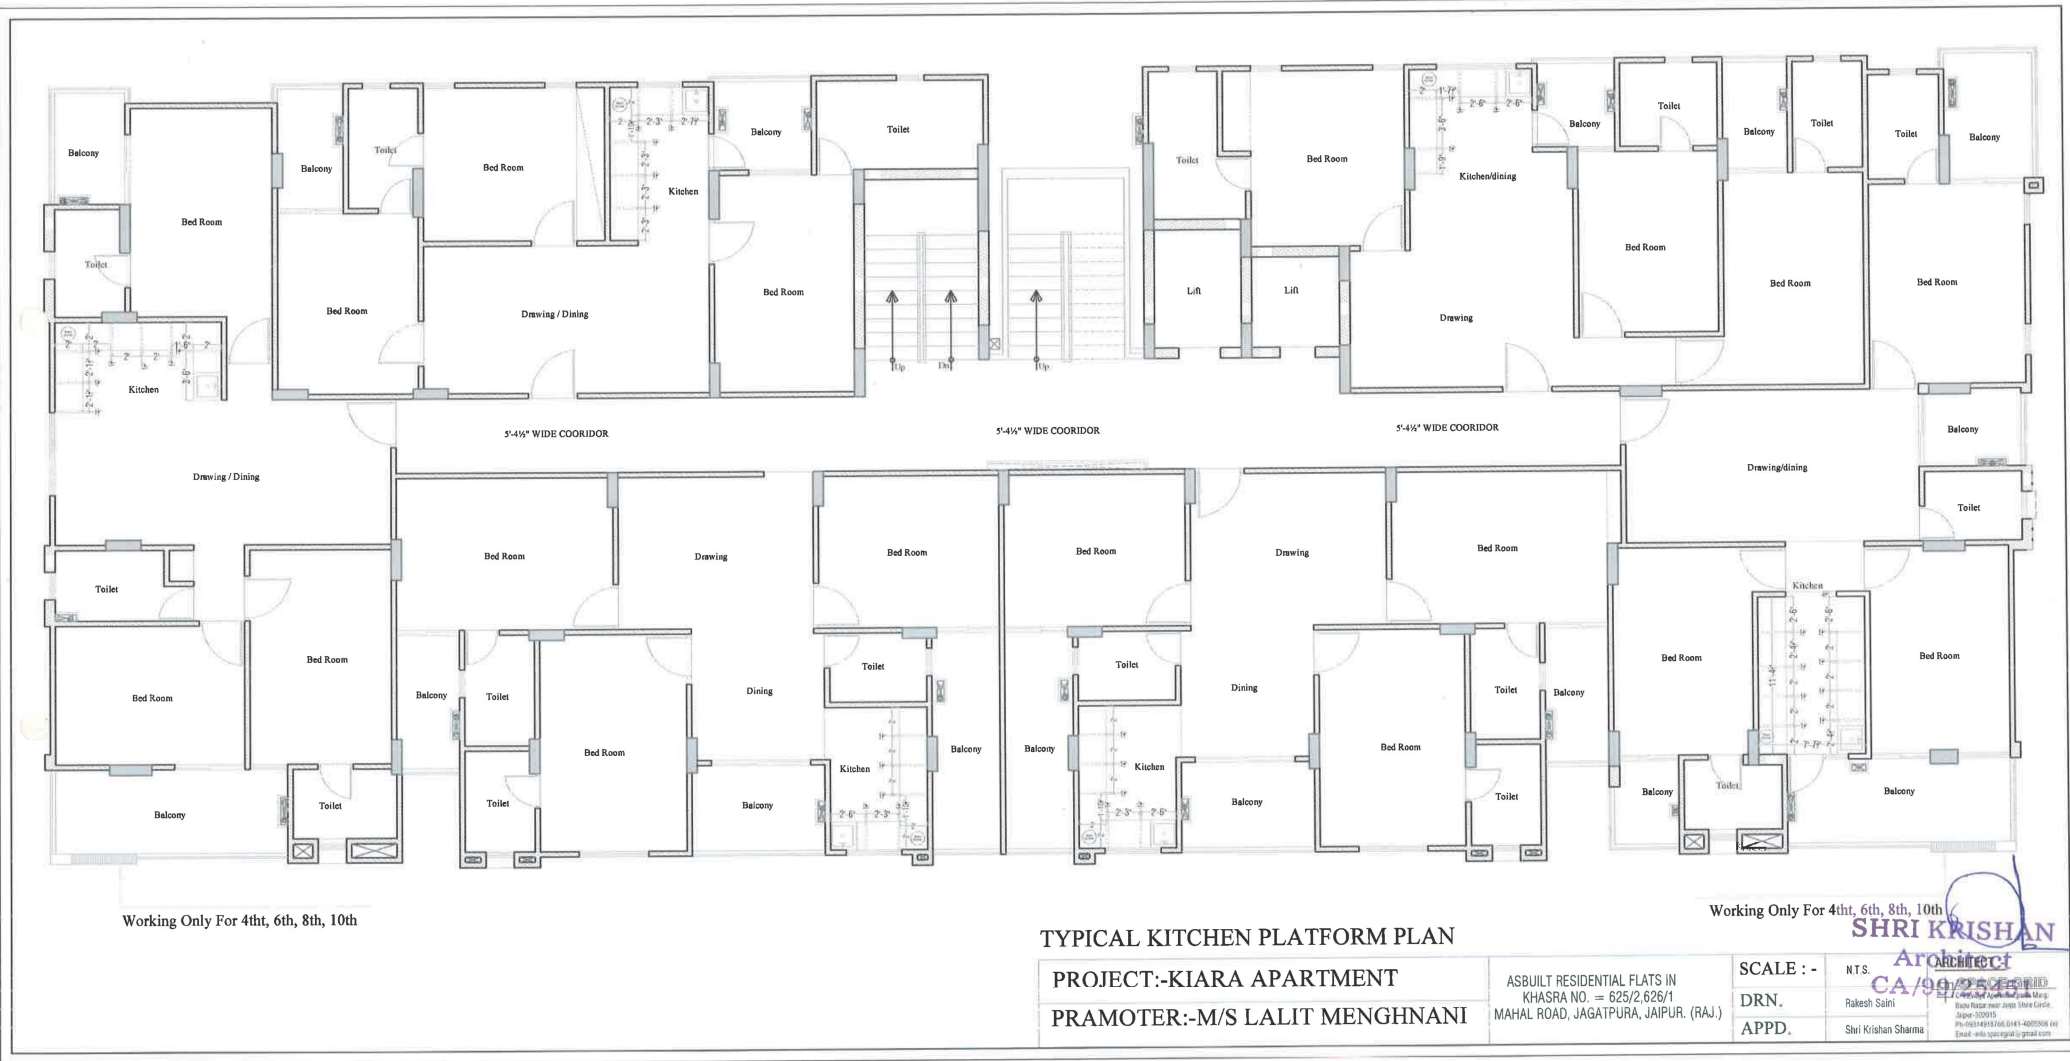

TYPICAL KITCHEN PLATFORM PLAN

PROJECT:-KIARA APARTMENT
PRAMOTER:-M/S LALIT MENGHNANI

ASBUILT RESIDENTIAL FLATS IN
KHASRA NO. = 625/2,626/1
MAHAL ROAD, JAGATPURA, JAIPUR. (RAJ.)

SCALE : -	NTS.
DRN.	Rakesh Saini
APPD.	Shri Krishan Sharma

SHRI KRISHAN
Architect
CA/99/5525
C-10, 1st Floor, Jagatpura, Jaipur
Phone: 9829015151, 9829015152
Email: shrik@shriksharchitect.com



Front Elevation Working Drawing

PROJECT: KIARA APARTMENT
 PRAMOTER:- M/S LALIT MENGHNANI

ASBUILT RESIDENTIAL FLATS IN
 PHASE NO. - 02/02/07
 MAHAL ROAD, JAGATPURA, JALPUR (RAJ.)

SCALE -
 DRN.
 APPD.


SHRI KRISHAN
 Architect
 99/25451



SHRI KRISHNAN
Architect
CA/99/25451

ARCHITECT :-
 **SPACE GRID**
C-471, Kirti Nagar Extension, Durga
Bhau Nagar near Jyoti Shakti Circle
Japur - 302015
Ph-0031918766 0141-4005506

ARCHITECT :-
 **SPACE GRID**
C-471, Kirti Nagar Extension, Durga
Bhau Nagar near Jyoti Shakti Circle
Japur - 302015
Ph-0031918766 0141-4005506

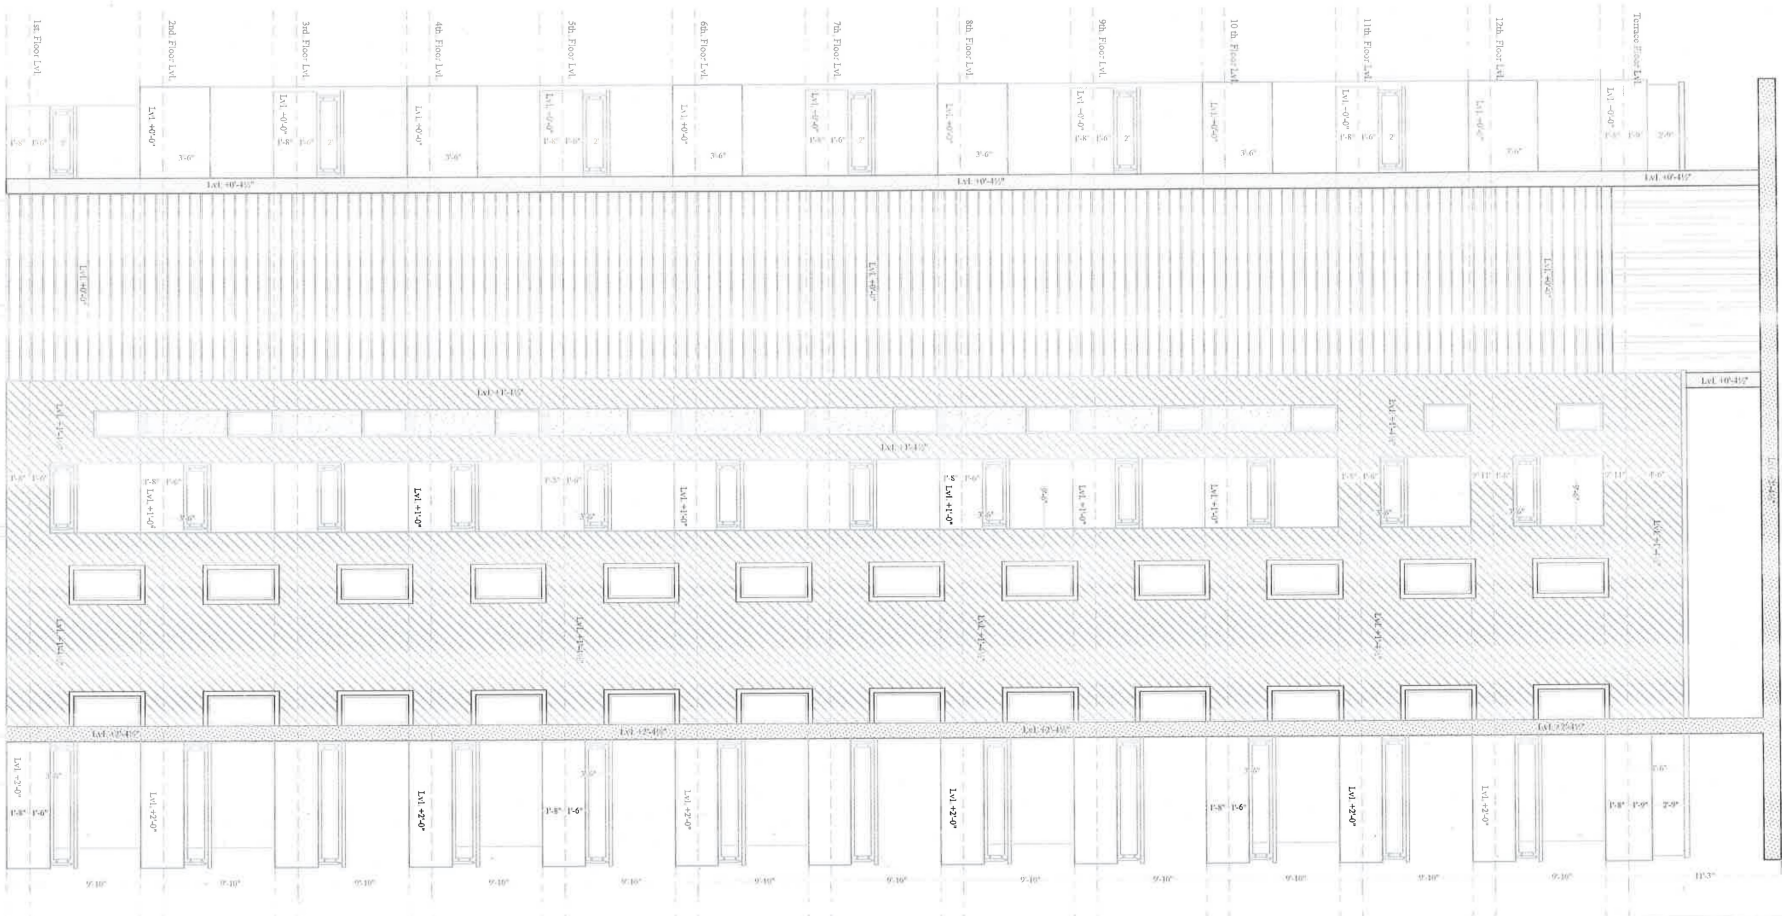

Site: L1 +1.00'
Road: L1 +0.00'


RIGHT ELEVATION WORKING DRAWING

PROJECT: KIARA APARTMENT
PRAMOTER:- M/S LAIT MEN NANI

ASSULT RESIDENTIAL PLATS IN
KHASRA NO - 625/2 626/1
MAHAL ROAD, JAGATPURA, JALPURA (RAJ)

SCALE: -
DRN
SITS
P. 10/08/2018

ARCHITECT: -
SHRI KRISHAN
Architect
CA/99/25451

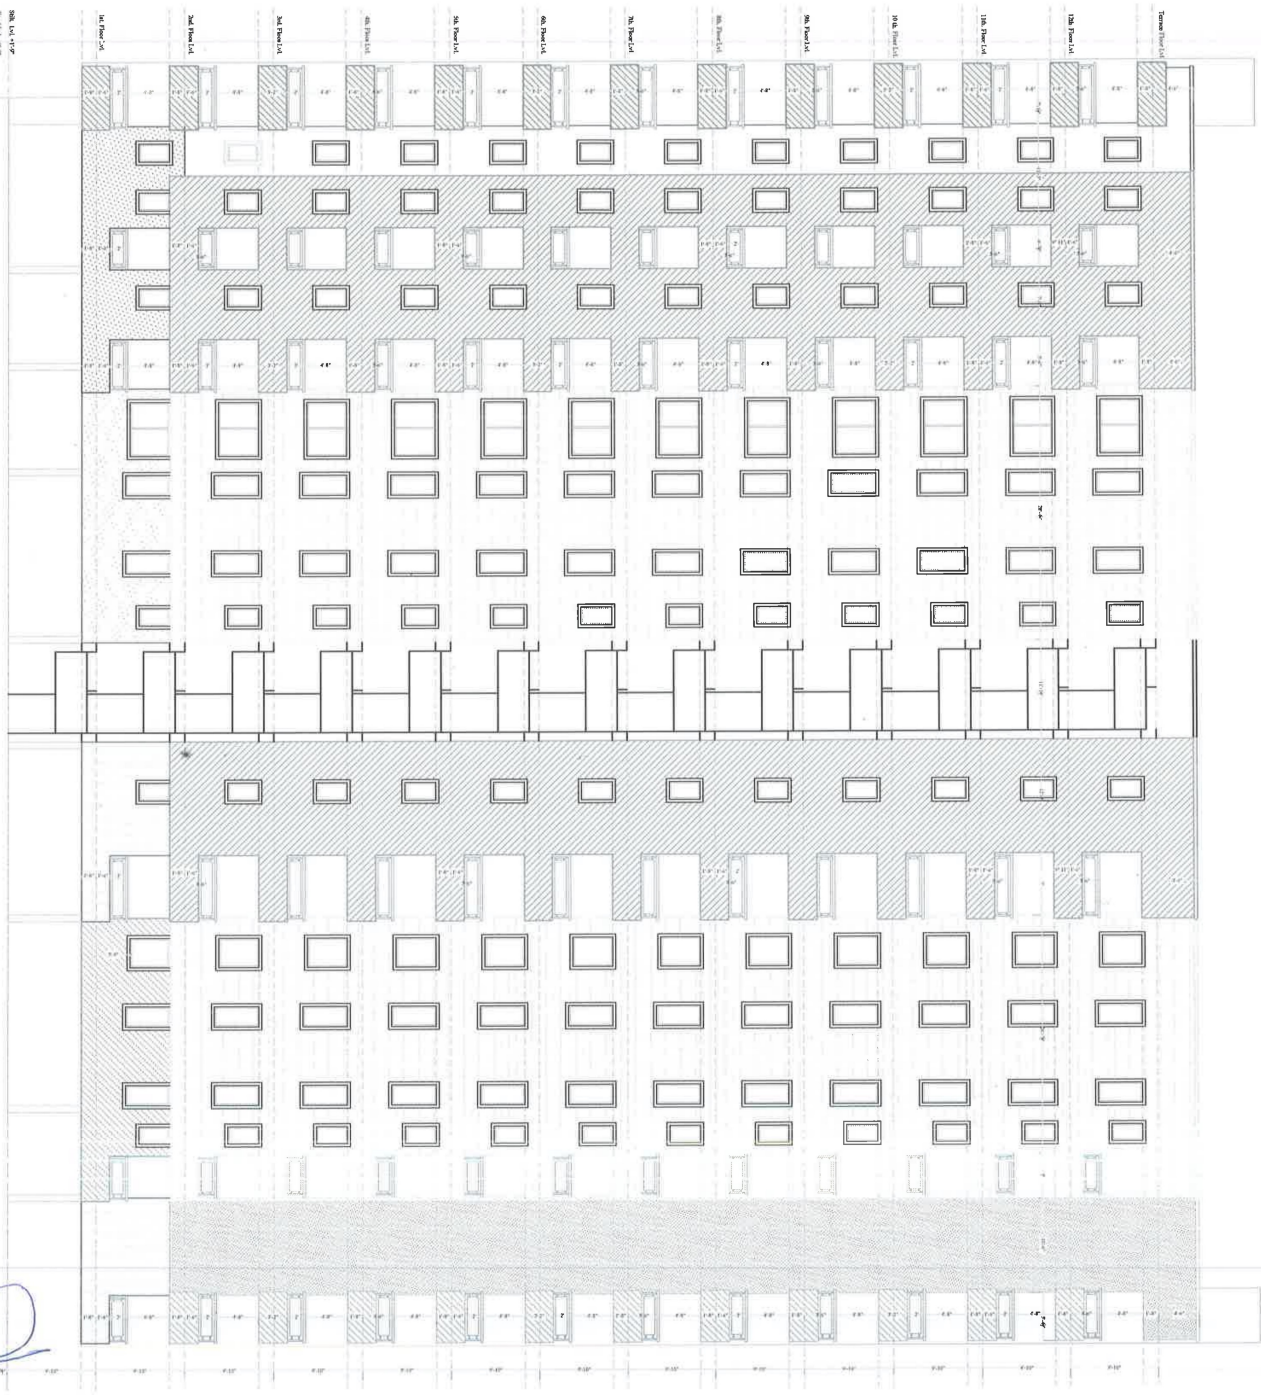

BACK ELEVATION WORKING DRAWING

PROJECT:- KIARA APARTMENT
PRAMOTER:- M/S LALIT MENGHINANI

ASMIT RESIDENTIAL PLATS N
KHASRA NO. = 652/2281
MAHAL ROAD, JAGATPURA, JAIPUR, (RAJ.)

SCALE: SHRI KRISHNAN
DRN. ARCHITECT
APPD. CA 1997/5/51

TERRACE FLOR

PROJECT:-KIARA APARTMENT	TERRACE FLOOR WORKING DRAWING	SCALE:- N=1:5	Architect CA/99/95/451
PRAMOTER:-M/S LALIT MENGHANI	PROJECT:- ASSTT. RESIDENTIAL PLANS IN KUSHA NO = 652/2/67 MAHA ROAD, AGRAHAR, (RAJ) 990	DRN	Sanjivan Sharma PRAJWANTHI 221111 PRAJWANTHI 221111

SHRI KRISHNAN

Architect
N.T.S.
CA/99/25/51
Raketen GmbH
Bismarckstrasse 100
D-10245 Berlin



PROJECT:-KIARA APARTMENT

FIRST FLOOR WORKING DRAWING

SCALE :-

N.T.S.

PRAMOTER:-M/S LALIT MENGHNANI

PROJECT:-

ASBUILT RESIDENTIAL FLATS IN
KHASRA NO. = 625/2,626/1
MAHAL ROAD, JAGATPURA, JAIPUR. (RAJ.)

DRN.

Rakesh Saini

APPD.

Shri Krishan Sharma

SHRI KRISHAN
Architect
CA/99/25451

ARCHITECT:-

SPACE GRID


C-43, Vidya Apartment, Paras Marg,

Bapu Nagar near Janta Store Circle,

Jaipur-302015

Ph.-09314918766, 0141-4005506 (o)

Email:-info.spacegrid@gmail.com

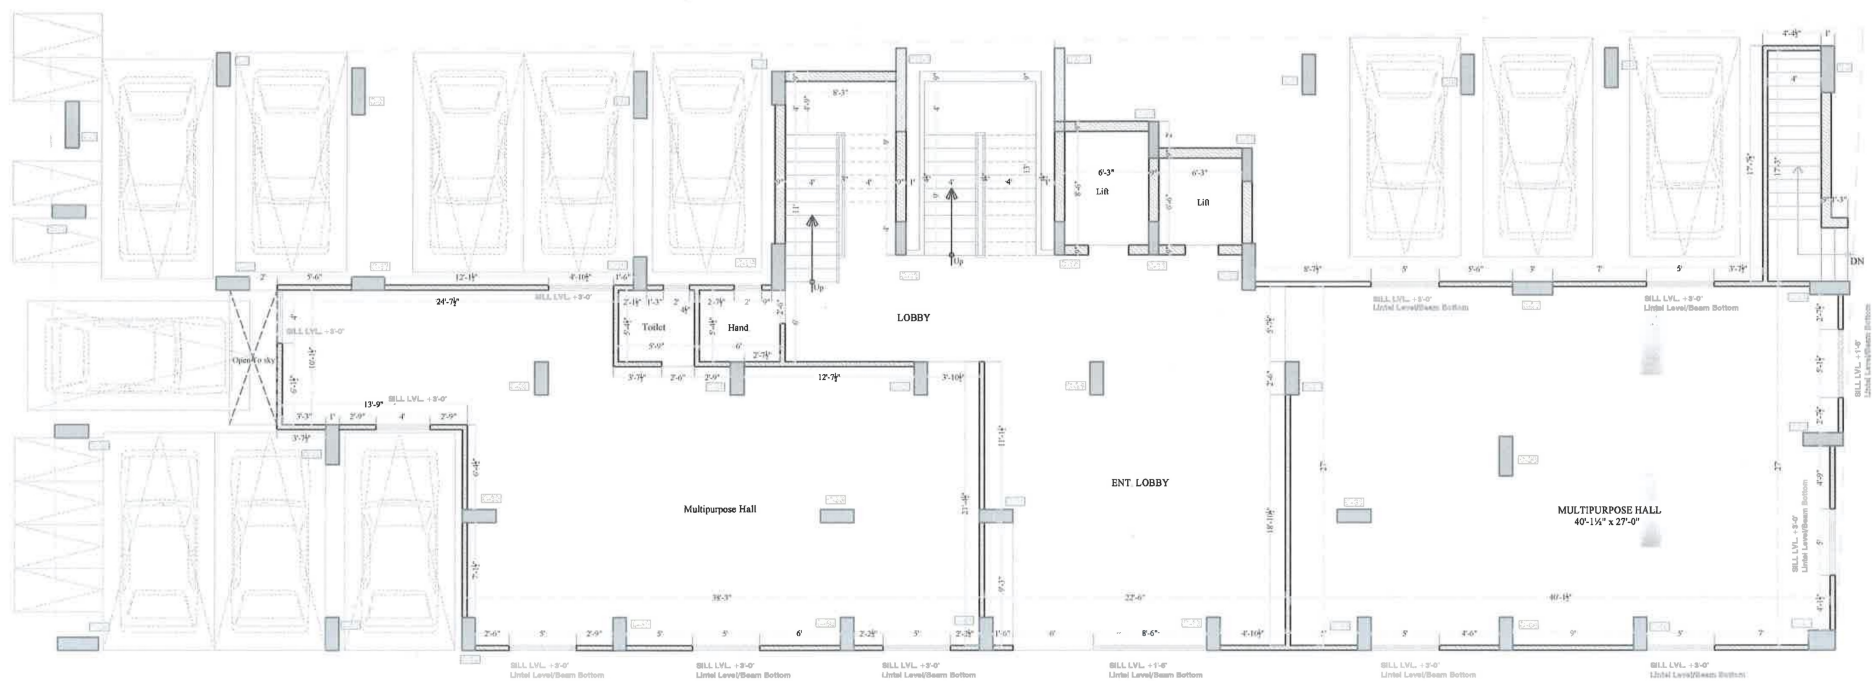

STILT FLOOR WORKING DRAWING

PROJECT:-KIARA APARTMENT

PRAMOTER:-M/S LALIT MENGHNANI

PROJECT:-

ASBUILT RESIDENTIAL FLATS IN
KHASRA NO. = 625/2,626/1
MAHAL ROAD, JAGATPURA, JAIPUR. (RAJ.)

SCALE :-

N.T.S.

DRN.

Rakesh Saini



APPD.

Shri Krishan Sharma

SHRI KRISHAN
Architect
CA/99/25451

ARCHITECT :-

SPACE GRID
C-49, Vidya Apartment, near Janta Store Circle,
Jaipur-302015
Ph-09314918766, 0141-4005506 (o)
Email:-info.spacegrid@gmail.com

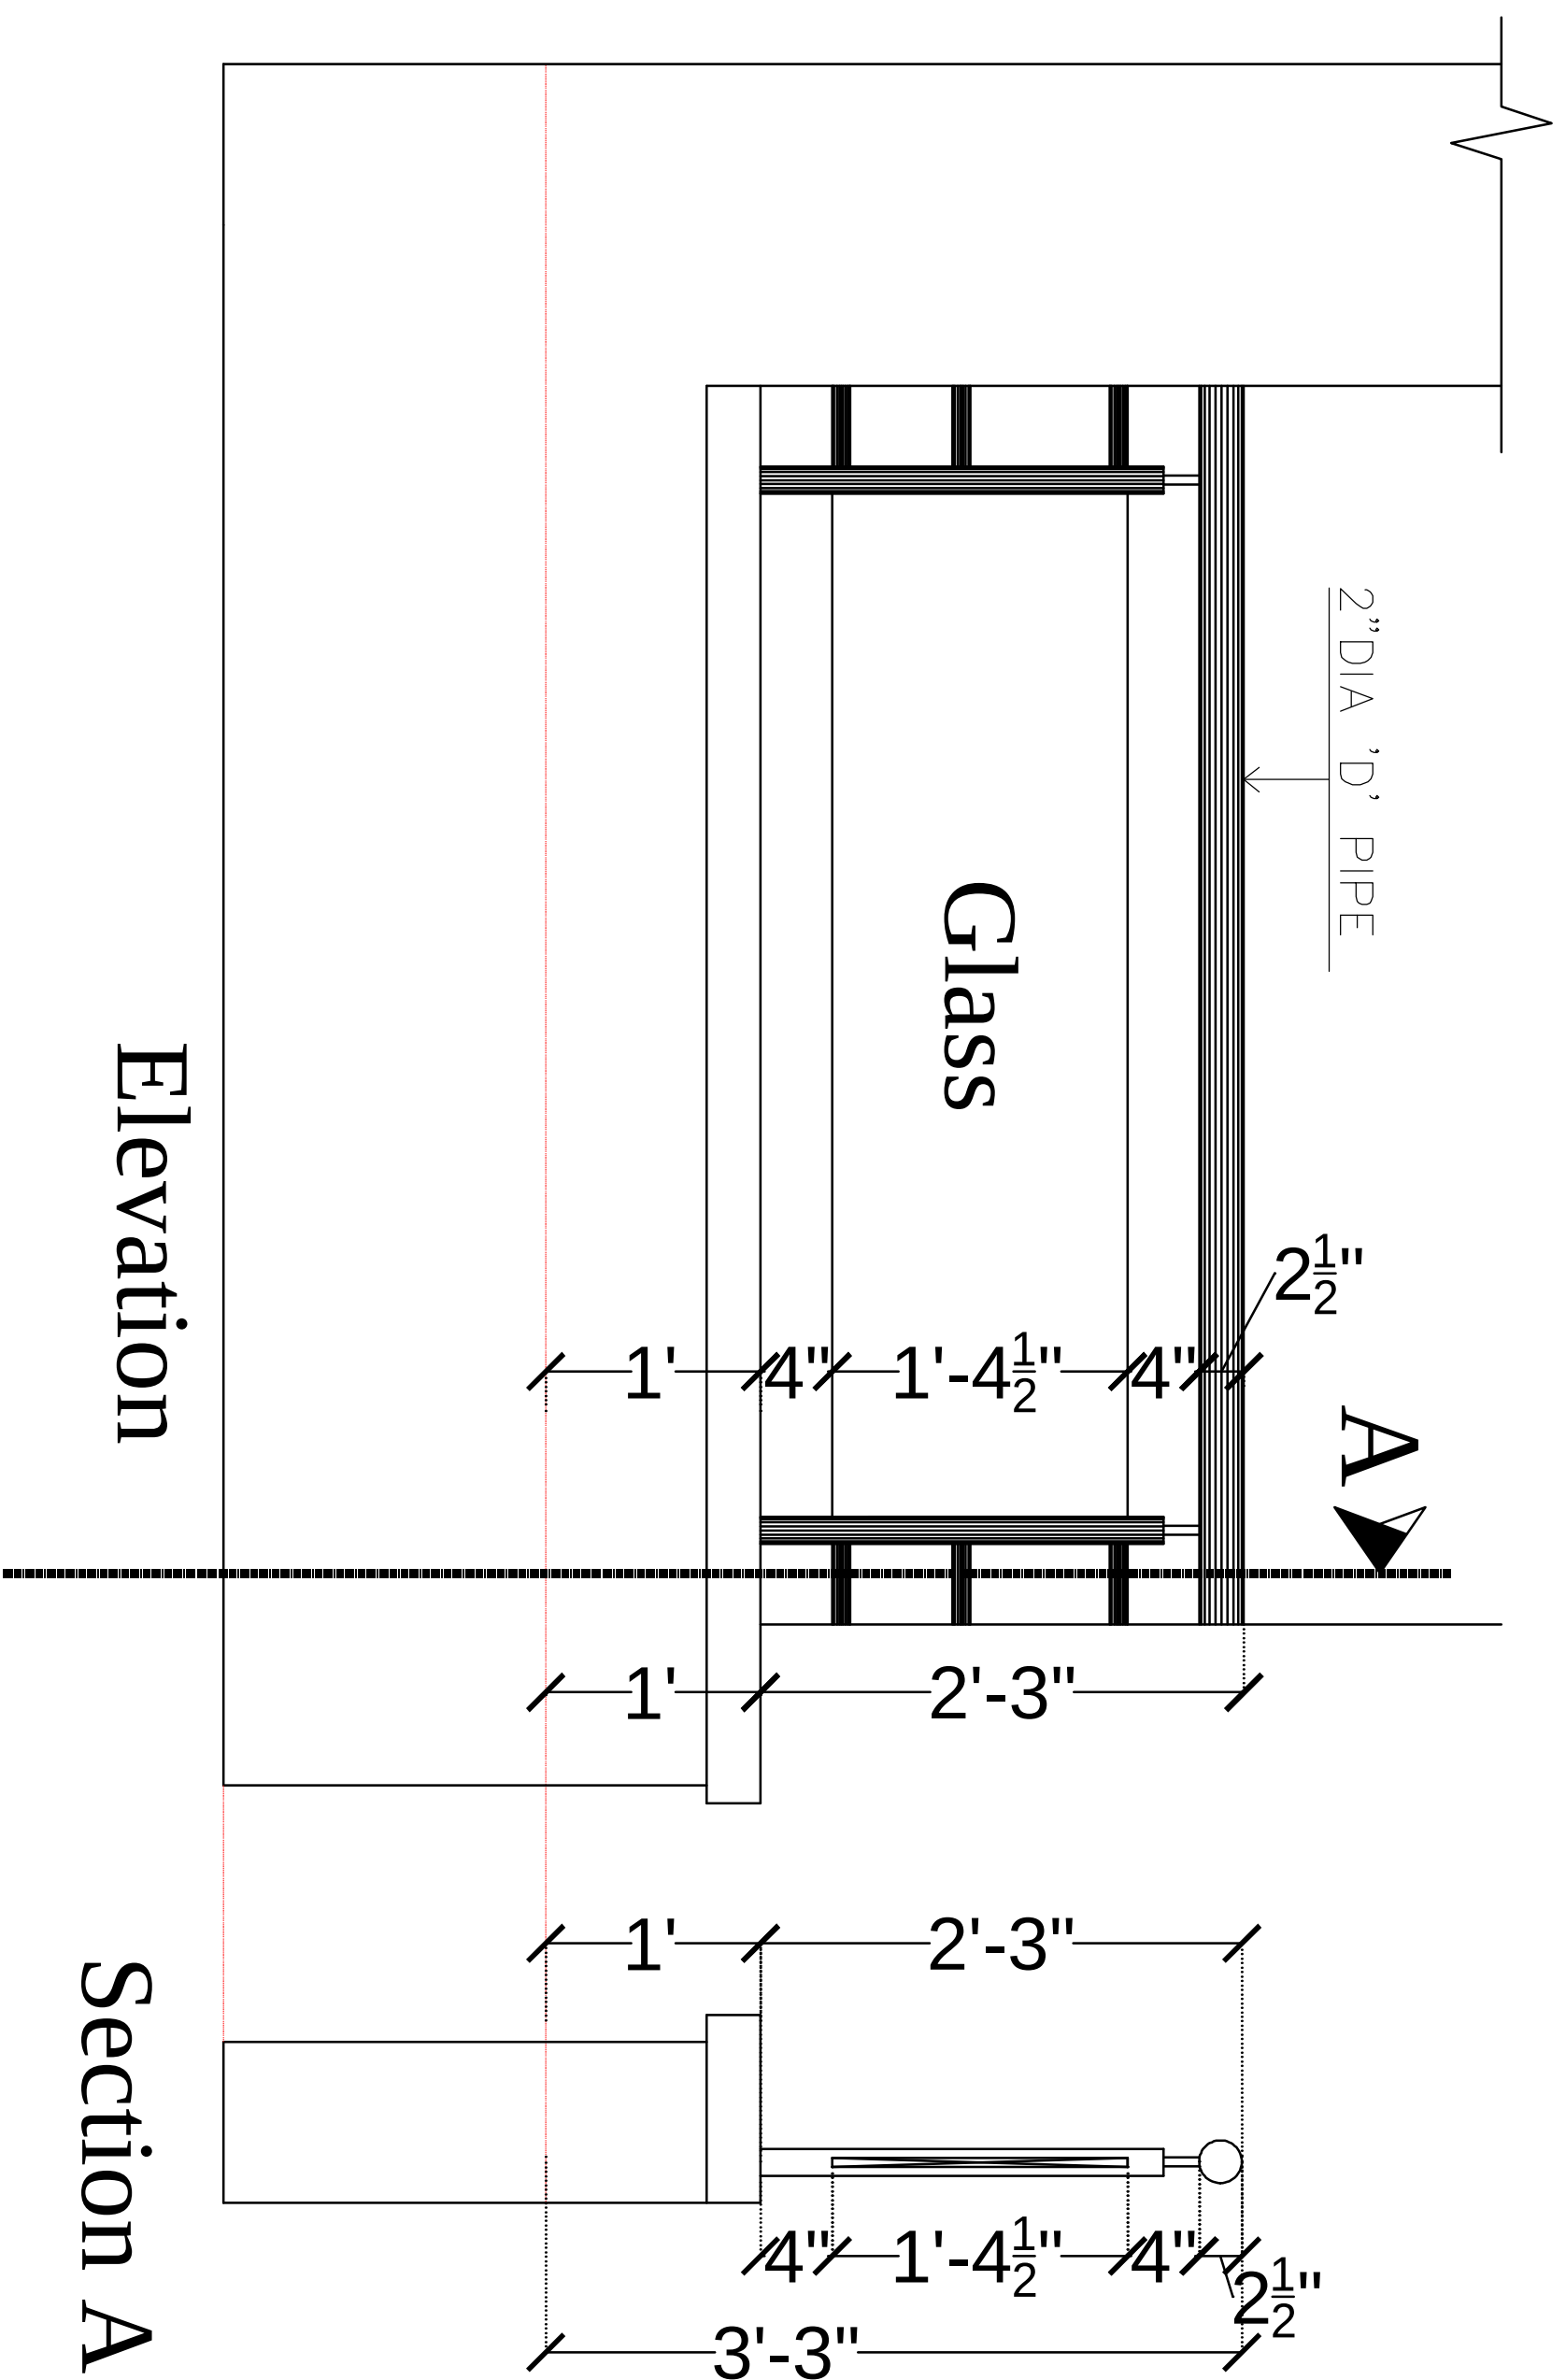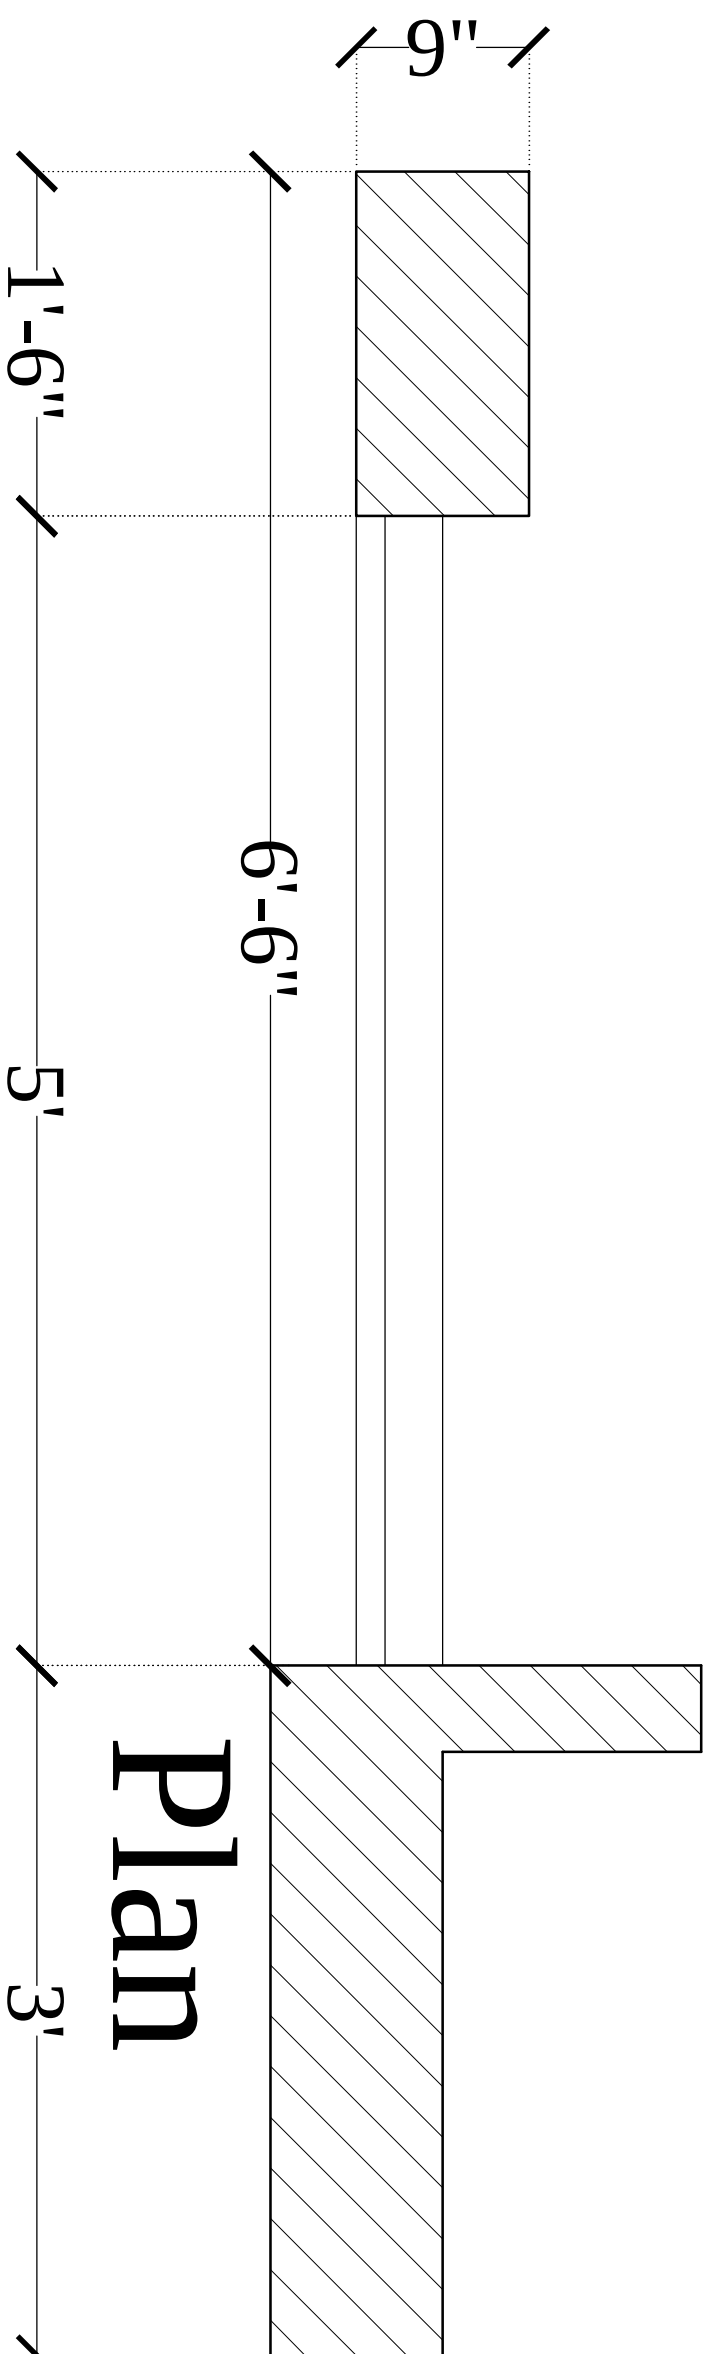

Elevation

Section A

SHRI KRISHAN
Architect
CA/99/25451

RAILING DETAIL (GLASS)

PROJECT:-KIARA APARTMENT

PRAMOTER:-M/S LALIT MENGHNANI

ASBUILT RESIDENTIAL FLATS IN
KHASRA NO. = 625/2, 626/1
MAHAL ROAD, JAGATPURA, JAIPUR. (RAJ.)

DRN. By:
RAKESH SAINI

Appd. By:
Shri Krishan Sharma

ARCHITECT:-



SPACE GRID

C-34 VIDYA APARTMENT PARAS MARG,
BAPU NAGAR, NEAR JANTA STORE CIRCLE,
JAPUR-302015
PH-0931497866 0141-4005506 (O)
Email:- info.spacegrid@gmail.com