



MANOJ BISHNOI
Architect
9225277

REVISIONS	
RECEIVED ON DATE	
ARCHITECT	
	AXIS 8-A,KAILASH PATH,SURAJ NAGAR, CIVIL LINES,JAIPUR. PH. 0141-2221035, 9829088373 E-Mail-axisarchitects@rediffmail.com
TITLE :-STILT FLOOR PLAN(AS BUILT DRAW	
GROUP HOUSING COMPLEX AT SURYA NAGAR, ALWAR, RAJASTHAN	
PLOT NO GH-1	
SCALE :- NTS.	
DRG. NO. :- 11	DATE
DRAWN BY:-	
	


R O A D 9 MT WIDE

R O A D 9 MT WIDE

103.403m

61.570m

59.664m

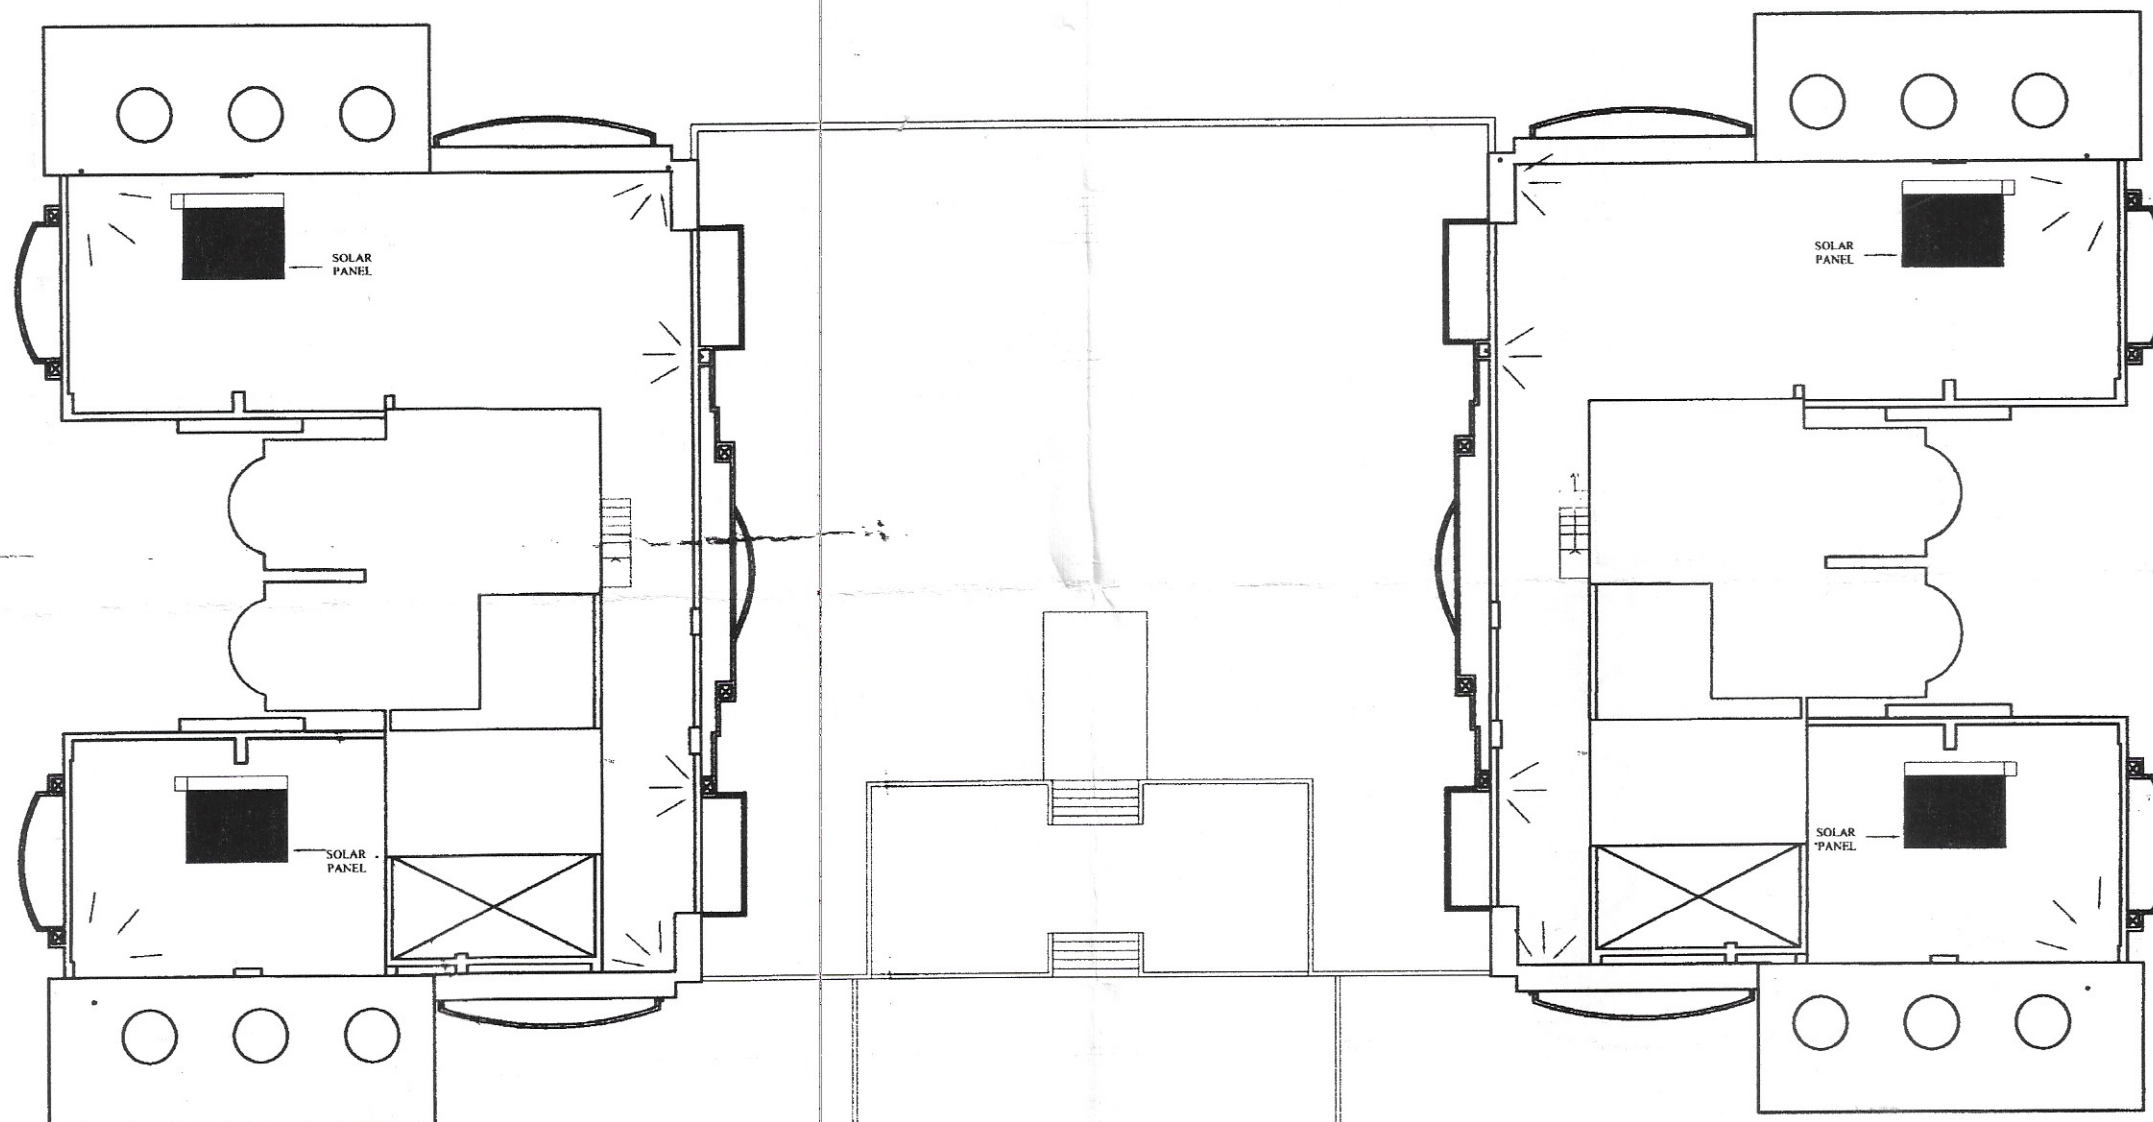

LVL=+1.2Mt
GARDEN

97.993m

R O A D 45 MT WIDE

TO DELHI

TO ALWAR

TERRACE FLOOR RAIN WATER DRAINAGE PLAN

A. Ch. Pathak
Project Manager (C)
MBCC (I) LTD.

PATIL
LIMITED

PROJECT TITLE :-
GROUP HOUSING
COMPLEX AT SURYA NAGAR,
ALWAR, RAJASTHAN , PLOT NO GH-1

DRAWING TITLE :-
TERRACE FLOOR RAIN WATER DRAINAGE PLAN
(AS BUILT DRW.)

SCALE :- 1 : 200

DATE-

DRG. NO.-18

MANOJ BISHNOI
Architect
COA No. CA/99/25277

NORTH

