


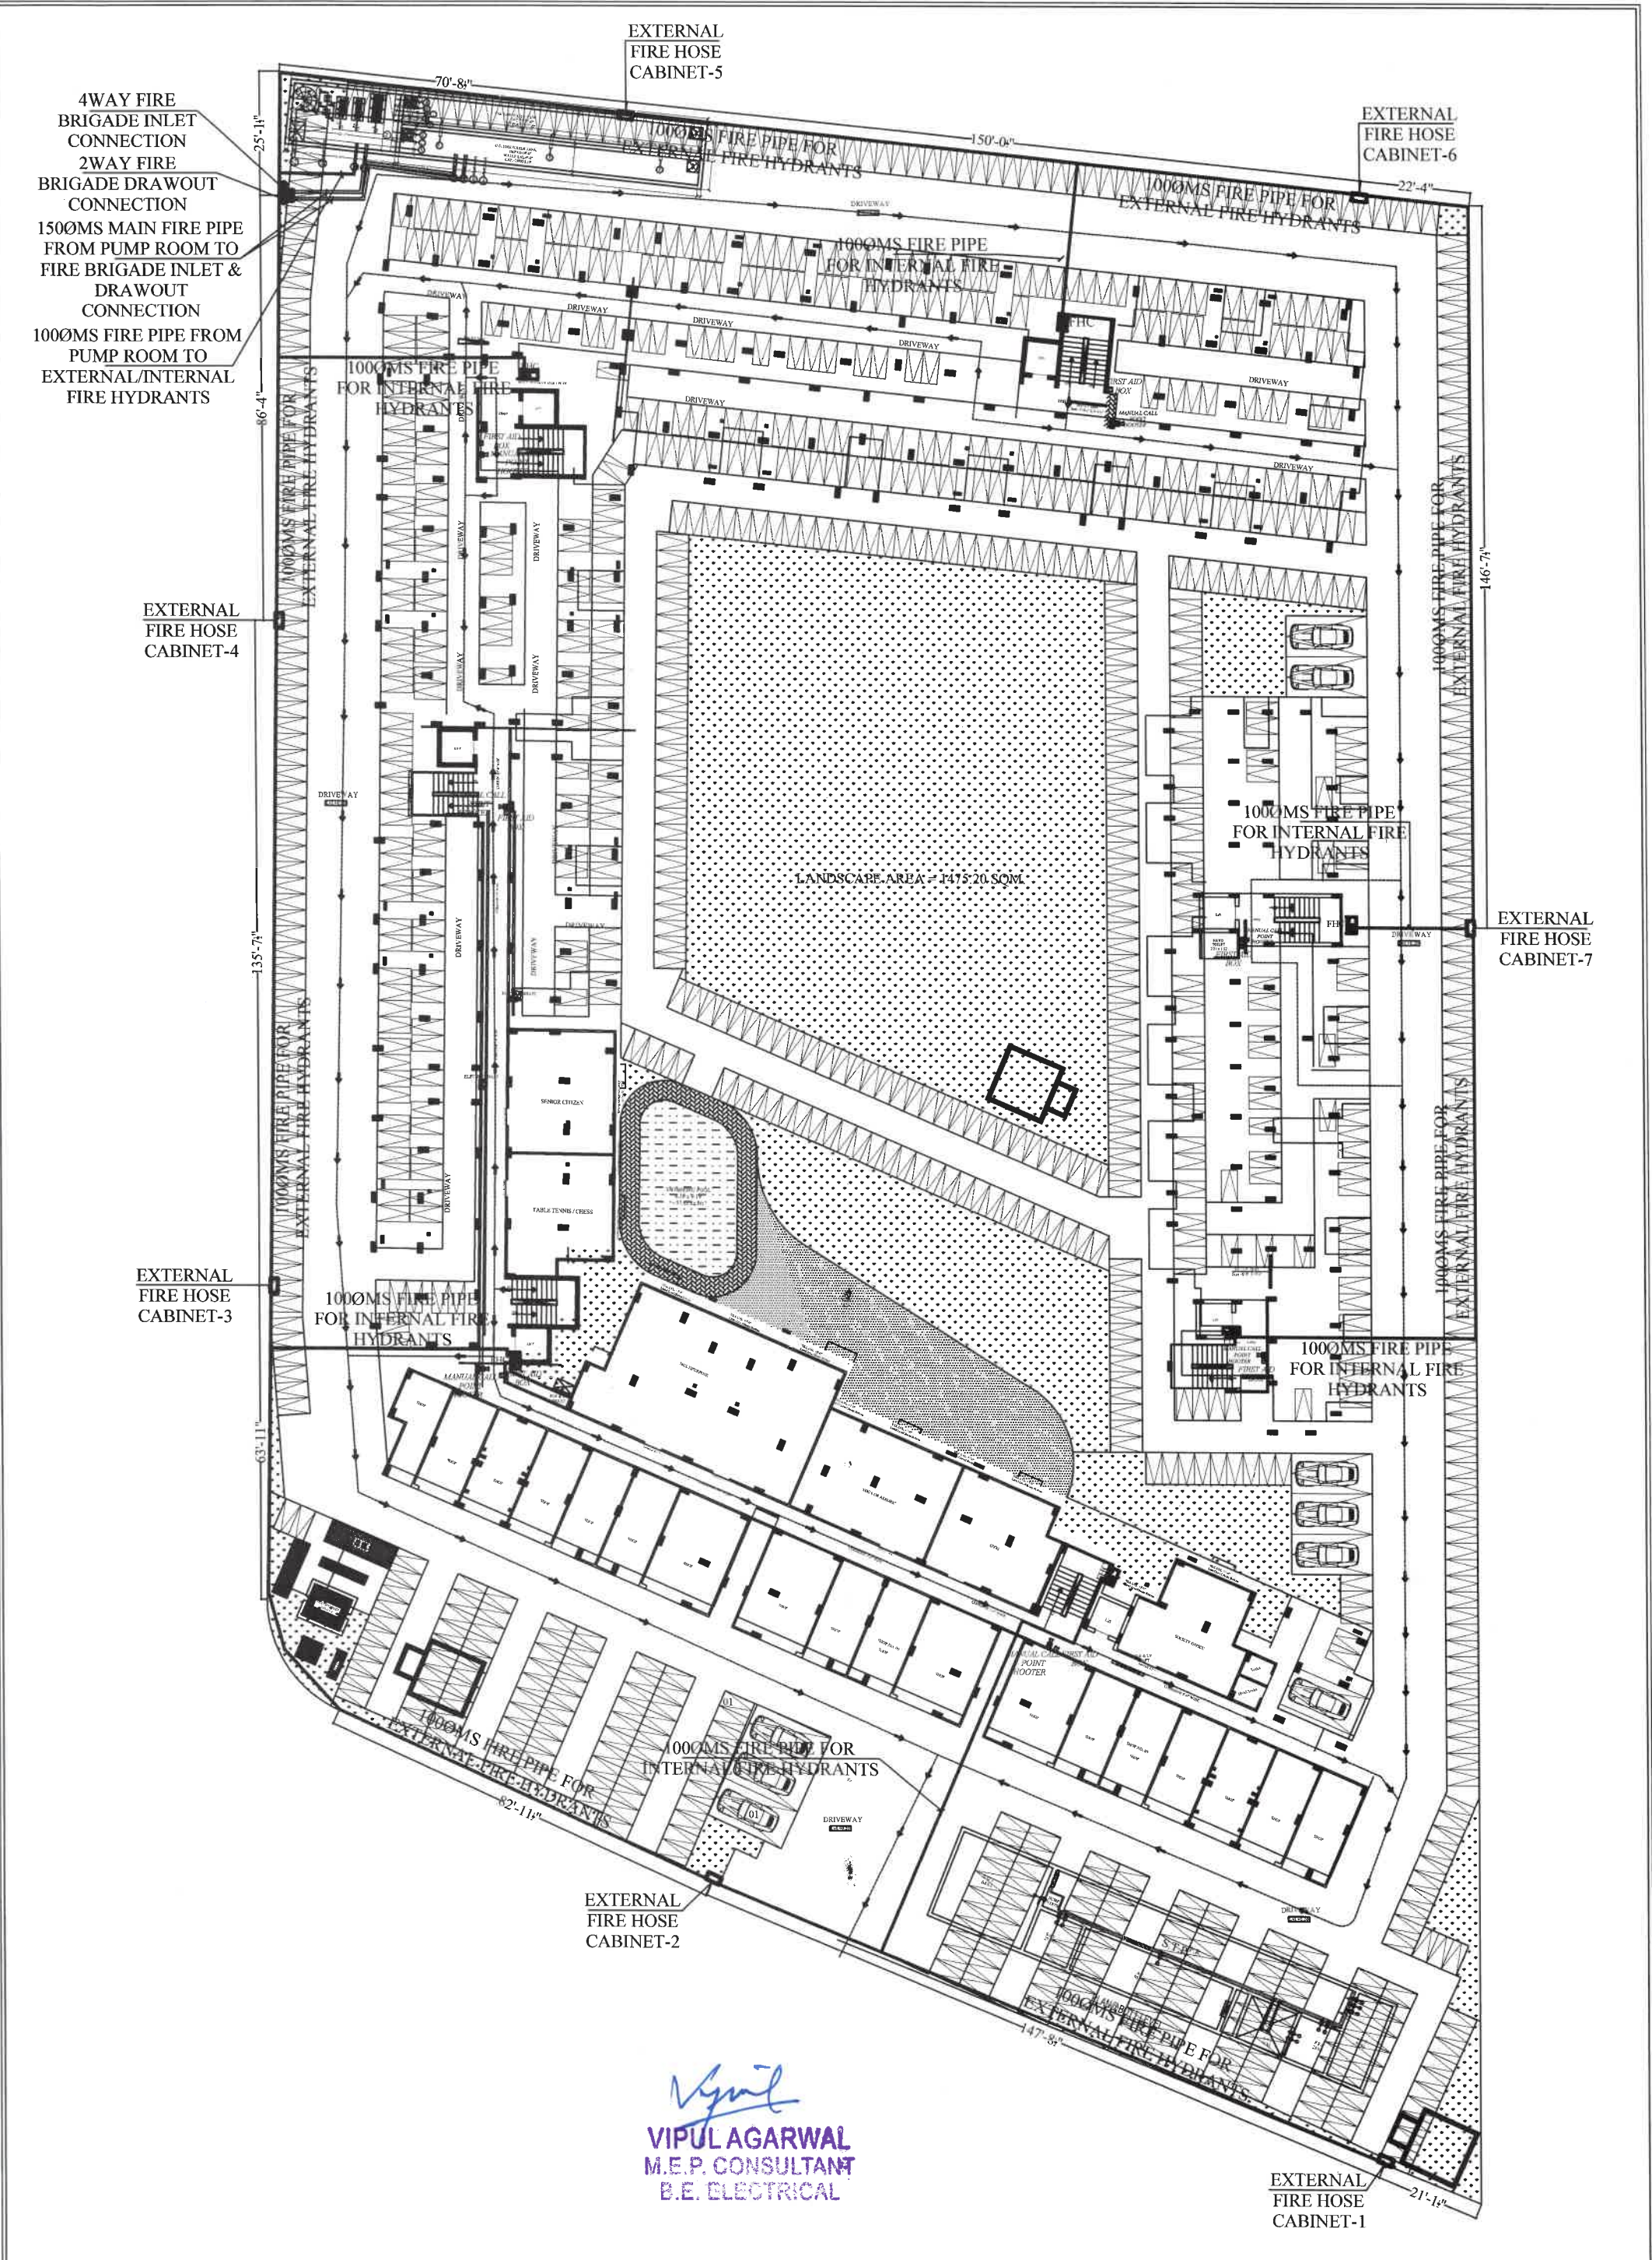

Vipul
VIPUL AGARWAL
M.E.P. CONSULTANT
E.E. ELECTRICAL

DRAWING TITLE:- SITE EXTERNAL FIRE HYDRANT & FIRE PIPE ROUTE PLAN		PROJECT:- AS BUILT GROUP HOUSING PLOT UNDER CHIEF MINISTER'S JAN AWAS YOJANA-2015 KHASRA NO - 210 & 211 AT VILLAGE - RAMSINGHPURA URF RAMPURA, TEH. - SANGANER, JAIPUR.	ARCHITECT:- SPACE GRID C-49, VIDYA APARTMENT, PARAS MARG, BAPU NAGAR, NEAR JANTA STORE CIRCLE, JAIPUR-302015 PH-09314918766, 0141-4005506 (O) Email:-info.spacegrid@gmail.com	SERVICES CONSULTANT: VIPUL CONSULTING, F 9 / 440 , Keshav Marg Chitrakut Scheme, Jaipur PH-91-0-93146-10438 , 0141-2440946 Mail:vipul8599@yahoo.com	SCALE = 1:125 DRAWN BY:- VIJESH CHECKED BY:- SANJAY APPROVED BY:- VIPUL AG. DATE:- 23-12-2022
---	--	--	--	--	---